

<b><i>Rathlin Energy</i></b>	Applies To: Rathlin Energy	<b>RE-05-EPRA-WN- SP-004</b>
Prepared By: Jonathan Foster	Uncontrolled, If Printed	Rev: 1.00

EMS SUPPORTING DOCUMENTATION - EPRA - WEST NEWTON EXPLORATORY OPERATIONS - SITE PLANS

---

# West Newton Wellsite Site Plans Exploratory Operations

---

This document contains proprietary information belonging to Rathlin Energy (UK) Limited and shall be used only for the purpose for which it was supplied. It shall not be copied, reproduced, disclosed or otherwise used, nor shall such information be furnished in whole or in part to third parties, except in accordance with the terms of any agreement under which it was supplied or with the prior consent of Rathlin Energy (UK) Limited and shall be returned upon request.

© Copyright of Rathlin Energy (UK) Limited

<b>Rev:</b>	<b>Prepared By:</b>	<b>Checked By:</b>	<b>Approved By:</b>	<b>Issued:</b>
1.00	Jonathan Foster	Tom Selkirk	D Montagu-Smith	16/01/2014

<b><i>Rathlin Energy</i></b>	Applies To: Rathlin Energy	<b>RE-05-EPRA-WN- SP-004</b>
Prepared By: Jonathan Foster	Uncontrolled, If Printed	Rev: 1.00

**EMS SUPPORTING DOCUMENTATION - EPRA - WEST NEWTON EXPLORATORY OPERATIONS - SITE PLANS**

\*\*\* Page Left Blank Intentionally \*\*\*

<b>Rev:</b>	<b>Prepared By:</b>	<b>Checked By:</b>	<b>Approved By:</b>	<b>Issued:</b>
1.00	Jonathan Foster	Tom Selkirk	D Montagu-Smith	16/01/2014



**Key:**  
 Site Boundary



**Rathlin Energy (UK) Limited**  
 8 Wimpole Street  
 London  
 W1G 9SP

**Job Title:**  
 West Newton Wellsite

**Drawing Title:**  
 Site Plan


**Scale:** 1:5,000 (Print A3)

**Date:** 16th January 2014

**Drawn By:**  
 Jonathan Foster

**Drawing No:**  
 RE-05-EPRA-WN-SP-004-01

**Rev:** 0

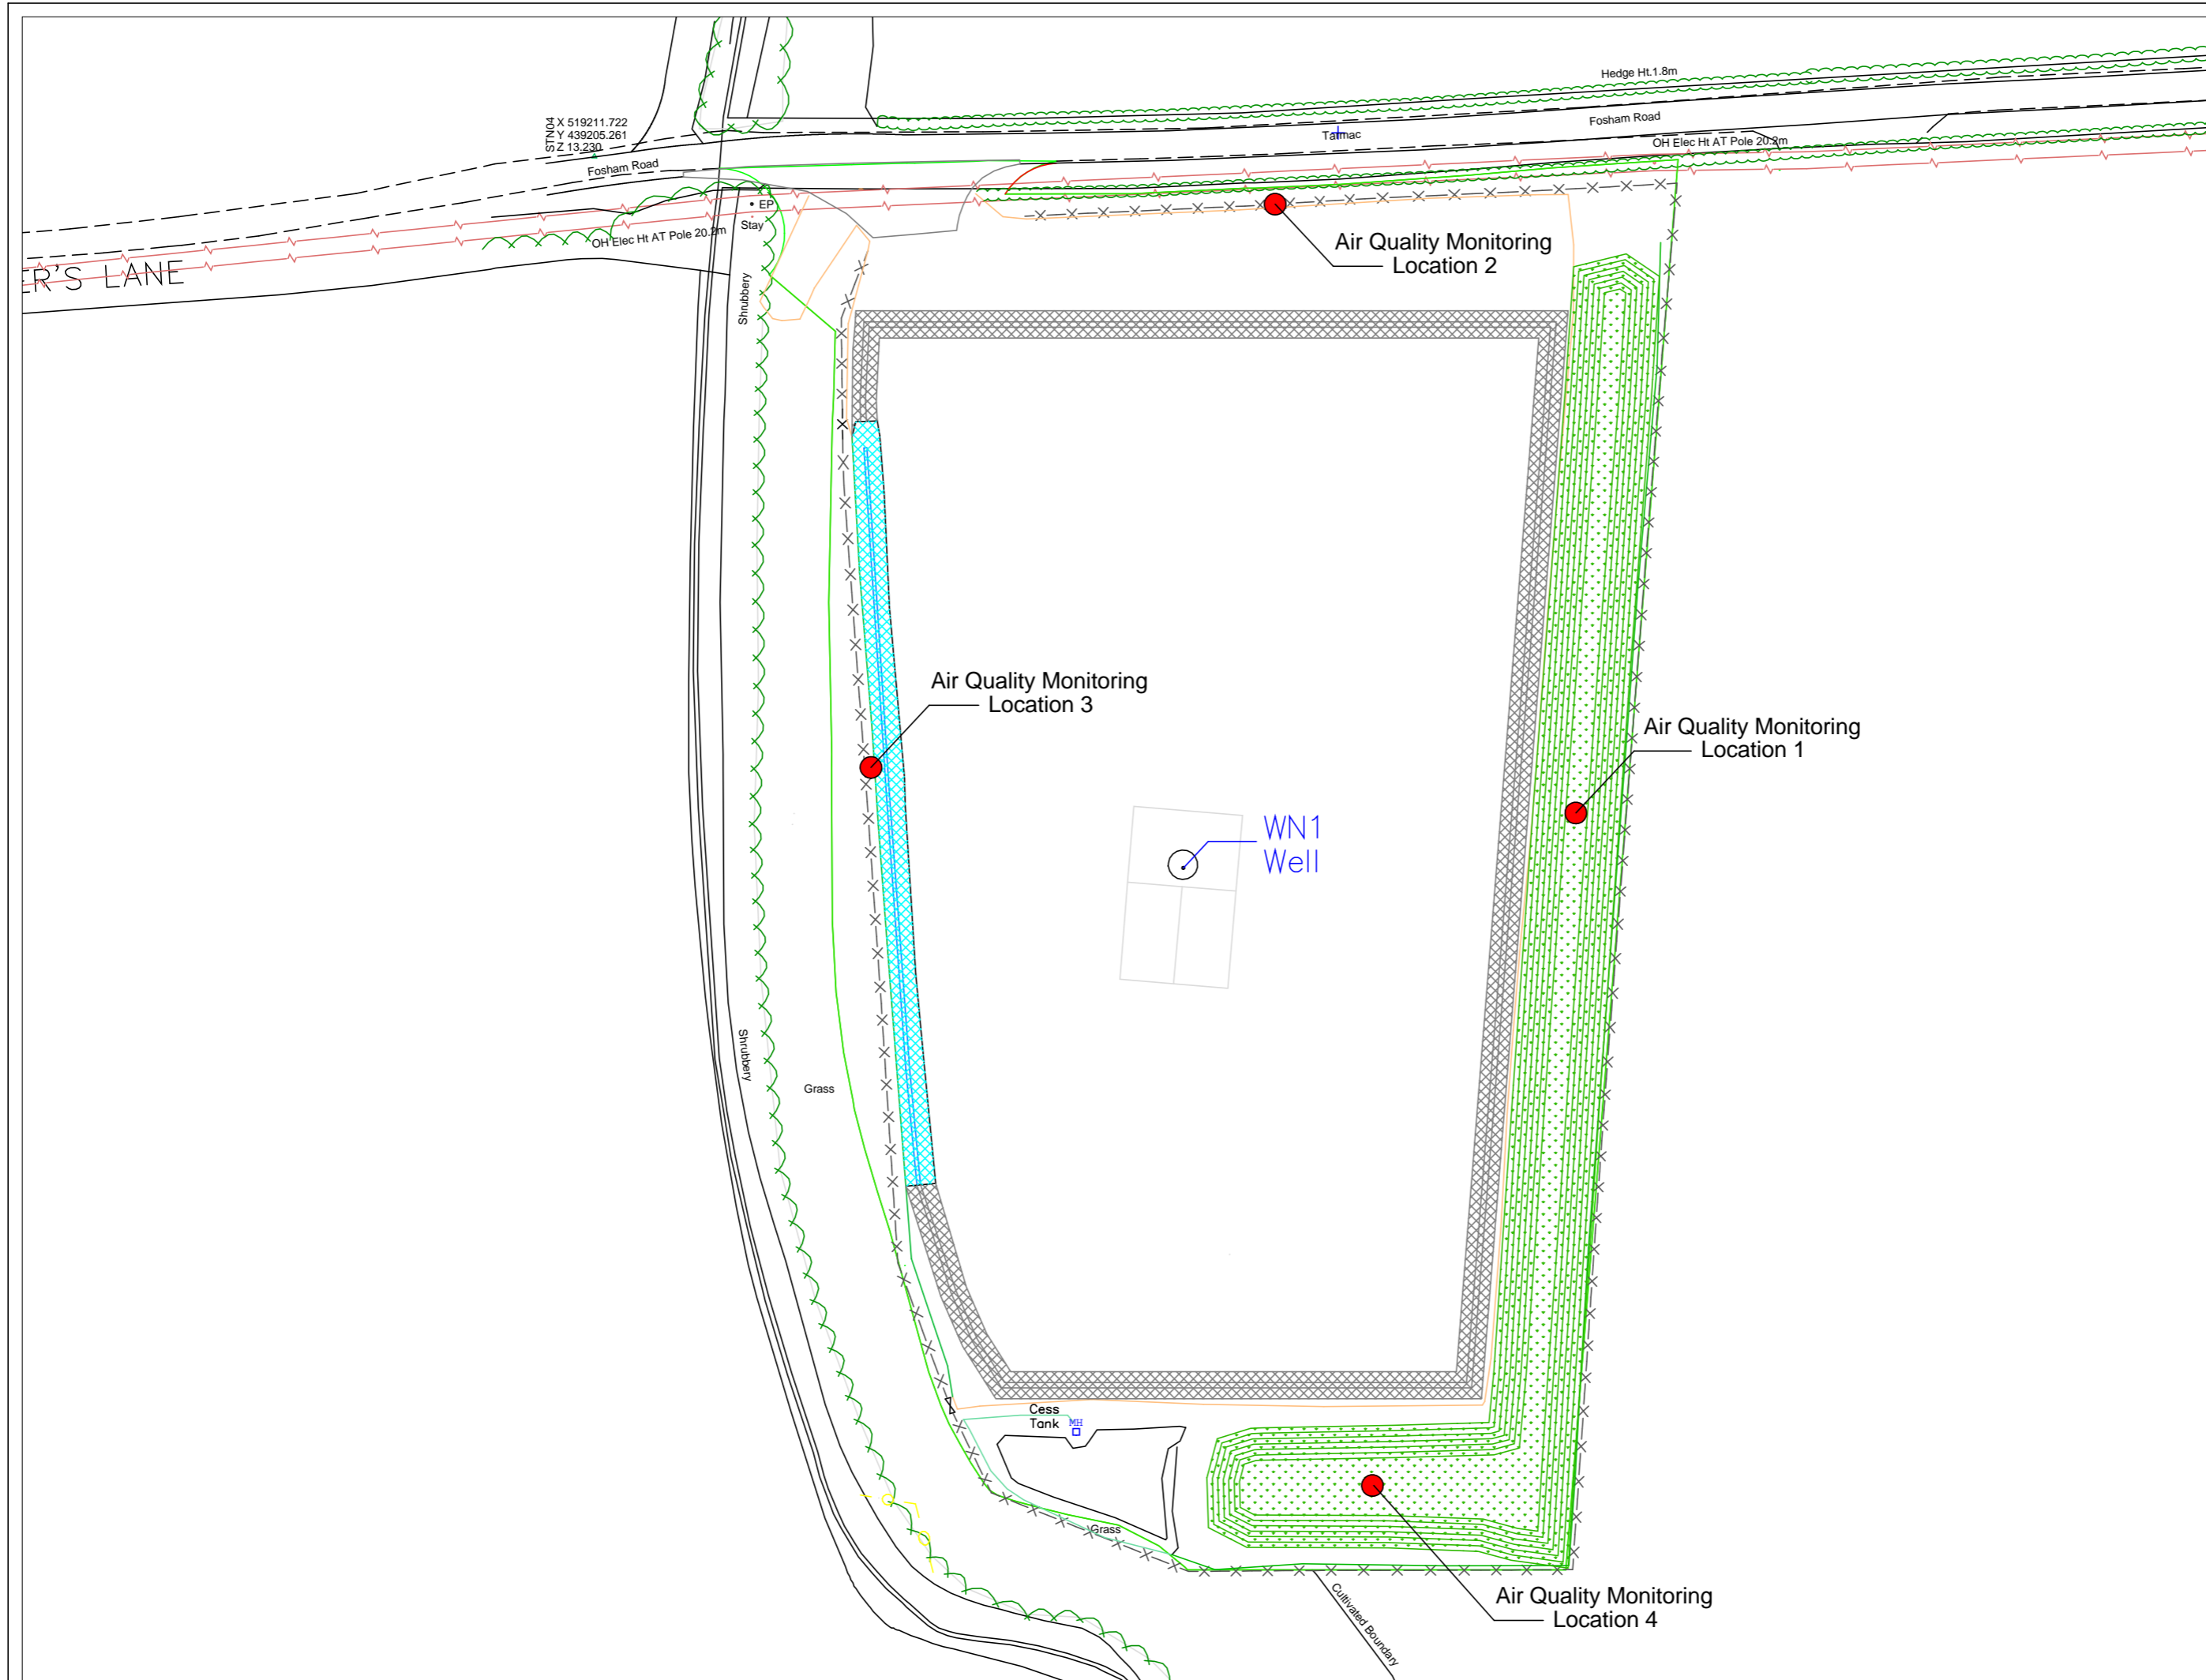

**Key:**

Site Boundary	
Topsoil Storage Bund	
Open Perimeter Drainage Ditch	
Piped Perimeter Drainage Ditch	
Air Quality Monitoring Locations	



Rathlin Energy (UK) Limited  
 8 Wimpole Street  
 London  
 W1G 9SP

Job Title:  
 West Newton Wellsite

Drawing Title:  
 As-Built Plan

Scale: 1:500 (Print A3)

Date: 16th January 2014

Drawn By:  
 Jonathan Foster

Drawing No:  
 RE-05-EPRA-WN-SP-004-02

Rev: 0